


SUITE

12 449 PI.CA

750

12 449 SQ.FT

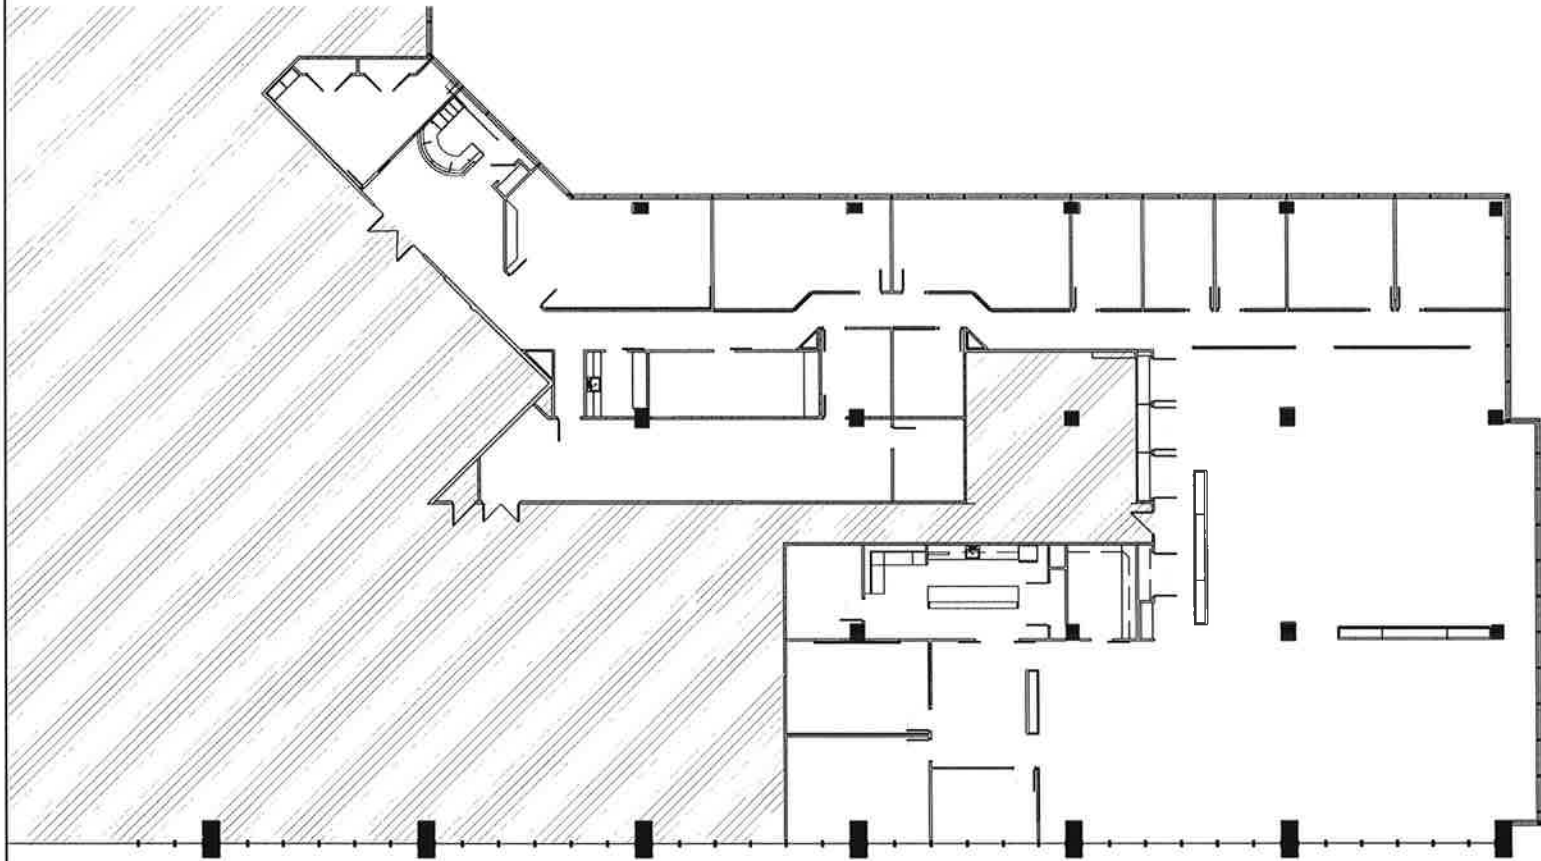

PLAN TEL QUE CONSTRUIT / AS-BUILT PLAN

1801 MCGILL COLLEGE

REDBOURNE