


SUITE
1900

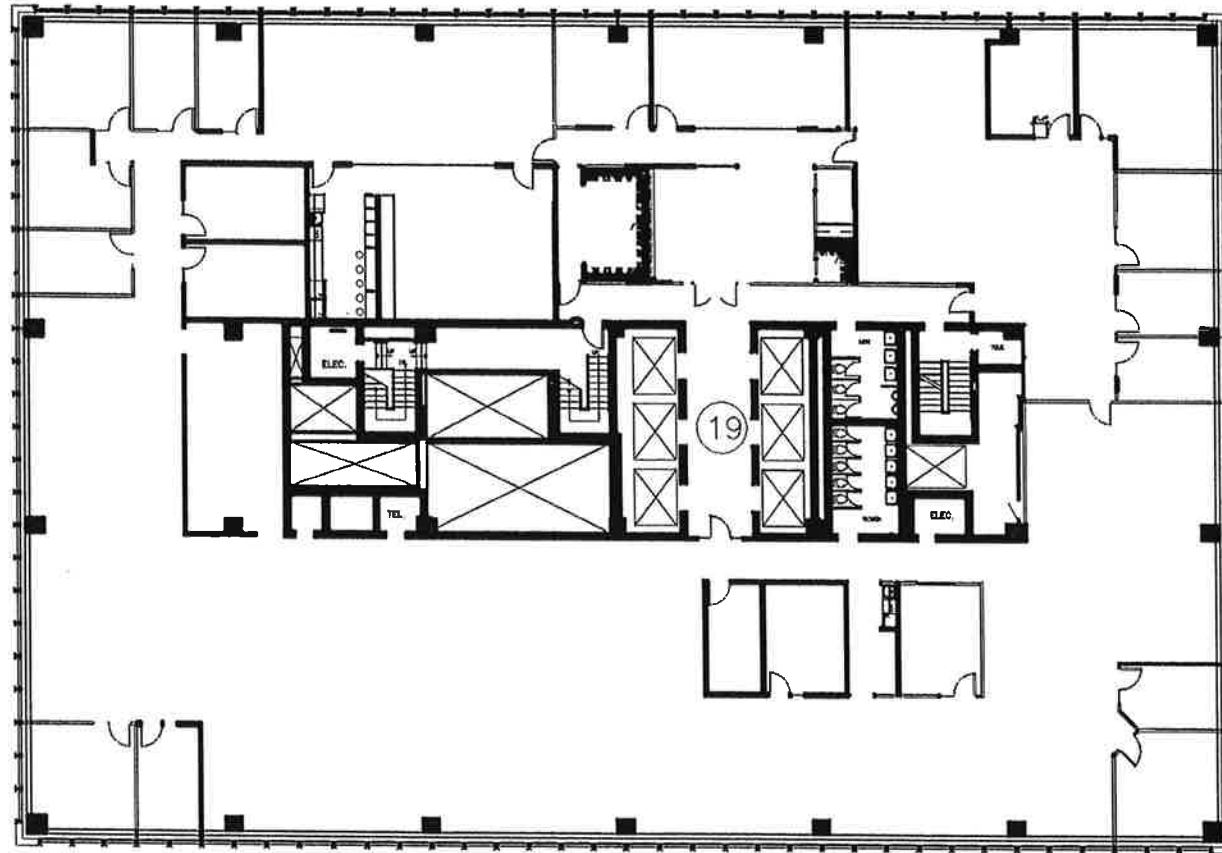

AS BUILT / TE QUE CONSTRUIT

630 RENÉ-LÉVESQUE O.

REDBOURNE