


SUITE
2400

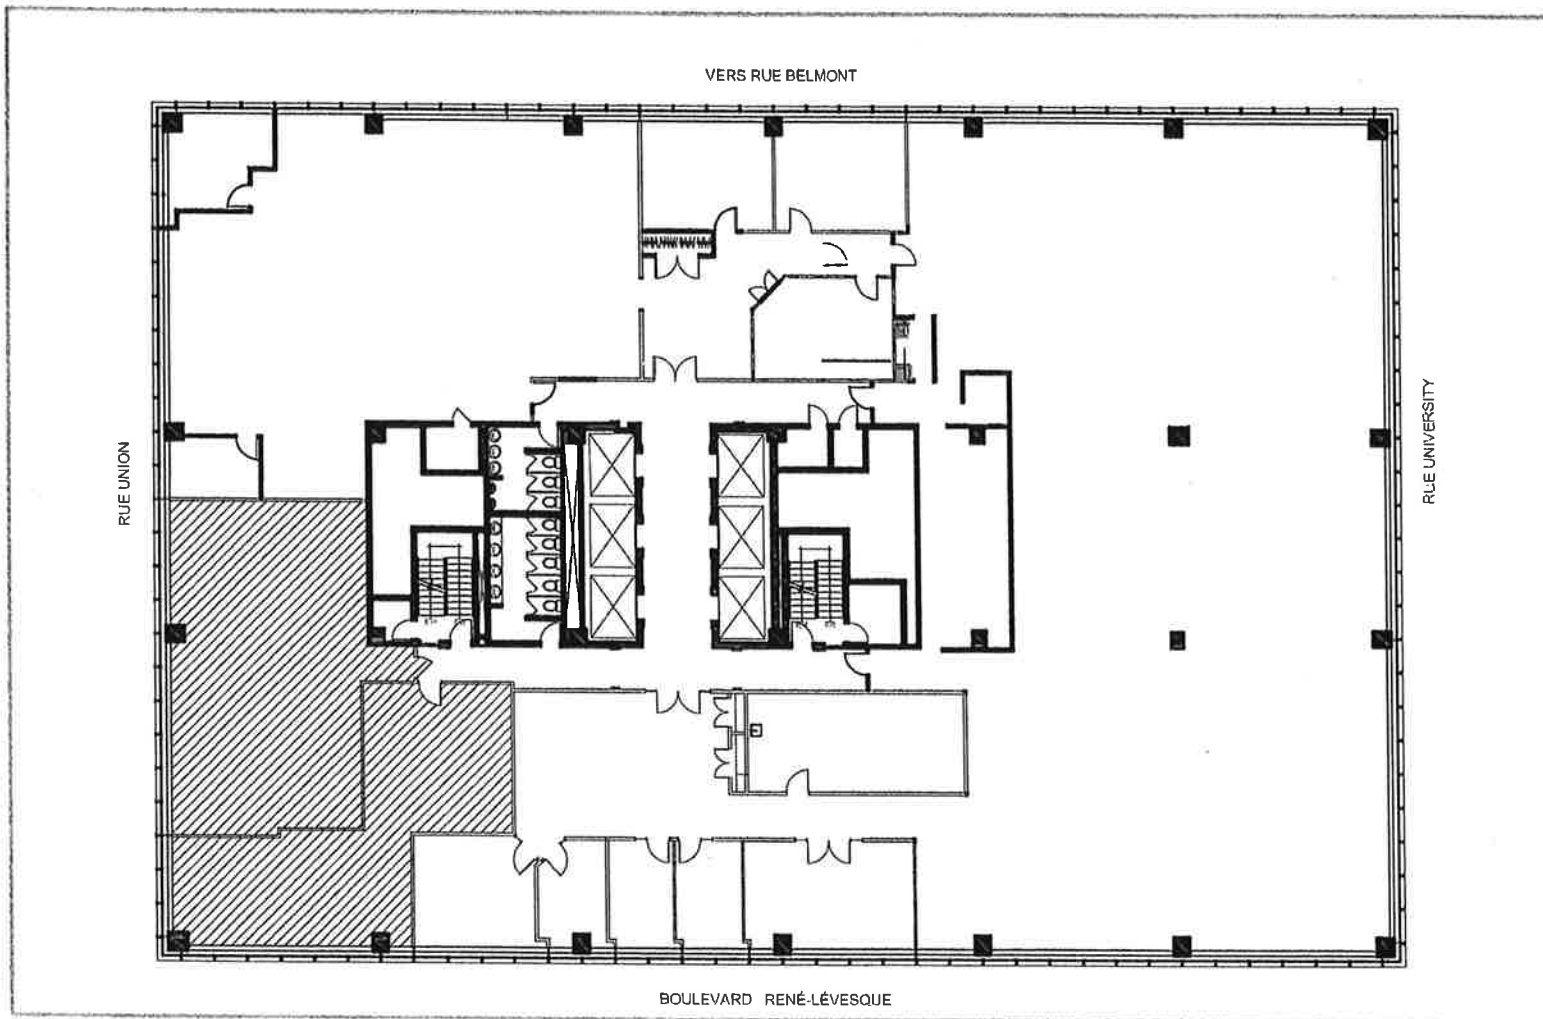

AS BUILT / TEL QUE CONSTRUIT

630 RENÉ-LÉVESQUE O.

REDBOURNE